





PLATE NO. 1

CONFIDENTIAL

ORDER OF PLANS		PLATE NO
	TITLE	
COVER SHEET		1
GENERAL DIMENSIONS & DATA		2
OUTBOARD PROFILE		3
INBOARD PROFILE		4
BRIDGES		5
FIRST & SECOND SUPERSTRUCTURE DECKS		6
MAIN DECK		7
SECOND DECK		8
SPLINTER DECK		9
THIRD DECK		10
FIRST PLATFORM		11
SECOND & THIRD PLATFORMS		12
HOLD		13
THIRD BOTTOM		14
INNER BOTTOM		15
SECTIONS		16, 17 & 18

SELECTED RECORD DRAWING  
SERIAL NO. BB61

CONFIDENTIAL

PER OPNAV INST S5513.3A  
ENCLOSURE 17 ID 03A-17

REVIEW FOR DECLASSIFICATION ON: 10 JAN 1995

DECLASSIFY ON: OADR

BOOKLET  
OF  
GENERAL PLANS

PREPARED AT THE  
NAVY YARD, NEW YORK

FORMERLY BU. NO. 355817

BU. NO. 578106



GENERAL DIMENSIONS  
HULL

LENGTH OVER ALL (MOLDED) 887'-3"  
LENGTH BETWEEN PERPENDICULARS 860'-0"  
BREADTH, EXTREME, TO OUTSIDE OF PLATING 108'-5"  
DRAFT, CORRESPONDING TO TRIAL DISPLACEMENT

MOLDED HEIGHTS OF BRIDGES &  
ELEVATED PLATFORMS AT  $\Phi$  OF SHIP

ABV  $\Phi$   
HEIGHT OF MAIN DECK AT STEM 89'-8 1/2"  
HEIGHT OF MAIN DECK AT STERN 80'-3"  
HEIGHT OF 1ST SUPERSTRUCTURE 60'-11"  
HEIGHT OF 2ND SUPERSTRUCTURE 60'-5"  
HEIGHT OF FLAG AND SIGNAL BRIDGE 75'-11"  
HEIGHT OF NAVIGATING BRIDGE 83'-5"  
HEIGHT OF PILOT HOUSE TOP 90'-11"  
HEIGHT OF 1ST LEVEL - FORWARD 98'-5"  
HEIGHT OF 2ND LEVEL - FORWARD 105'-11"  
HEIGHT OF 3RD LEVEL - FORWARD 113'-5"  
HEIGHT OF 4TH LEVEL - FORWARD 121'-7 1/2"  
HEIGHT OF 5TH LEVEL - FORWARD 129'-9 1/2"  
HEIGHT OF 6TH LEVEL - FORWARD 138'  
HEIGHT OF AFTER MAIN BATTERY DIRECTOR FLAT 83'-10"  
HEIGHT OF SPS-49 PLATFORM 162'-8"  
HEIGHT OF SPS-49 ANTENNA SERVICE PLATFORM 166'-8"  
MOLDED BASE LINE OF SHIP IS 2" ABOVE BOTTOM OF KEEL

CONFIDENTIAL

MASTS & LIGHTS

ABV DWL  
HEIGHT OF FWD ANCHOR LIGHT (WHITE) 58'-4 3/4"  
HEIGHT OF AFT ANCHOR LIGHT (WHITE) 43'-7 1/2"  
FWD MASTHEAD LIGHT (WHITE) 72'-7 1/8"  
AFT MASTHEAD LIGHT (WHITE) 128'-5 3/8"  
SIDE LIGHTS P/s (P-RED, S-GREEN) 28'-5 3/8"  
UPPER MOD. ACFT WRN & SHIPS TASK LTS (DUAL ARRAY) (RED) 167'-5 3/4"  
MIDDLE MOD & SHIPS TASK LTS (DUAL ARRAY) (WHITE) 158'-11 1/4"  
LOWER MOD & SHIPS TASK LTS (DUAL ARRAY) (RED) 150'-5 3/4"  
HOMING BEACON (WHITE) 147'-9 3/4"  
BLINKER LIGHTS P/s (WHITE) 125'-8 3/4"  
WAKE LIGHT (WHITE SPOT LT) 25'-0 3/4"  
STERN LIGHT (WHITE) 24'-0 1/4"  
STERN LIGHT (BLUE) 22'-10 1/4"  
STEERING LIGHT (WHITE) 45'-11"

ACCOMMODATIONS

BERTHING  
OFFICERS (98 WHICH INCLUDES CO, XO 112  
1 MARINE OFFICER, 2 GUEST  
CABINS AND VIP QUARTERS,  
PLUS 14 SURGE).  
CPO 90  
MARINE SERGEANT 2  
CREW 1593  
OTHER MARINE ENLISTED 23  
TOTAL 1820

BOATS

NO. OF BOATS	TYPE OF BOAT	NO. MEN EACH BOAT	TOTAL MEN
3	40 FT. UTILITY BOATS MK 34 OR 5	75	225
2	26 FT. MOTOR WHALE BOATS MK 10 OR 11	20	40
81	INFLATABLE LIFEBOATS MK 6	25	2025
2	33 FT. PERSONNEL BOAT MK 2	24	48

CONFIDENTIAL


REVISIONS

REV	PLATE	DESCRIPTION	DATE	BY
A	ALL	THIS DRAWING HAS BEEN CORRECTED TO AGREE WITH SHIP'S INSTALLATION BY SAN FRANCISCO NAVAL SHIPYARD AND IS DESIGNATED AS A SELECTED RECORD DRAWING (REF SAN FRANCISCO NAVAL SHIPYARD MAILING ORDER OF NOV. 7, 1981).	4/2/82	CRJ
B	ALL	PLAN BROUGHT UP TO DATE WITH LATEST SHIP INSTALLATIONS AND TO CONFORM WITH SHIP CHECK	2/15/86	
C	ALL	THIS DRAWING CORRECTED TO REFLECT THE REACTIVATION AND MODERNIZATION PROGRAM OF 1984. PLATE 3 THROUGH 15 REDRAWN FOR LEGIBILITY & ADDED PLATES 16, 17 & 18. <i>After</i>		

GENERAL DIMENSIONS & DATA  
BU NO. 578106  
8861 PLATE 2 OF 18




OUTBOARD PROFILE  
BU. NO. 578106  
SCALE: 1/16" = 1'-0"  
PLATE 3 OF 18

 



CONFIDENTIAL









CONFIDENTIAL

 

INBOARD PROFILE  
BU. NO. 578106  
SCALE: 1/16" 1'-0"  
PLATE 4 OF 18



CONFIDENTIAL

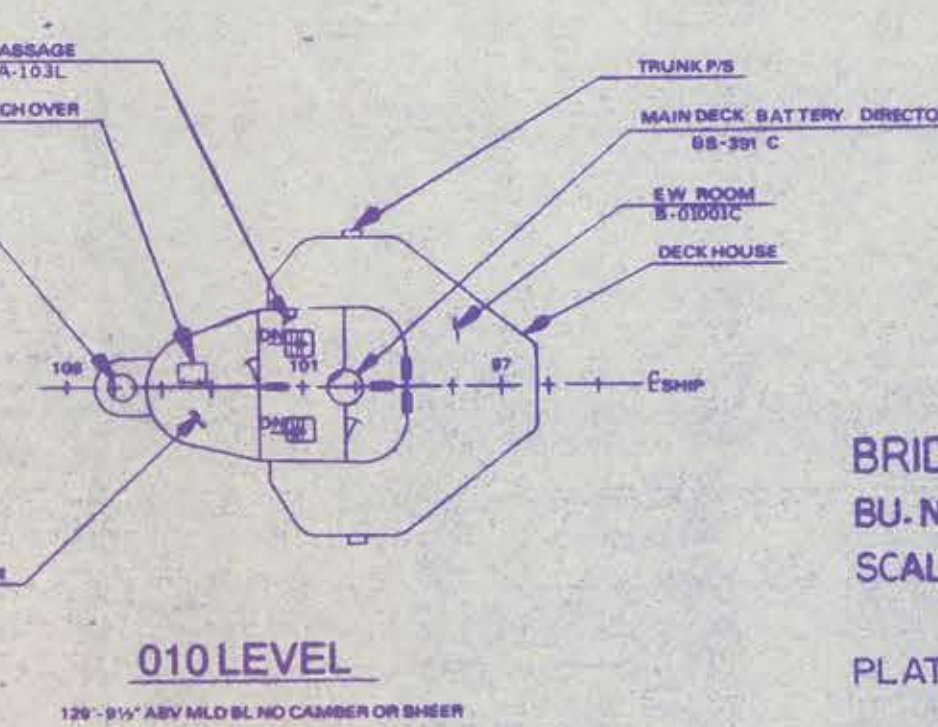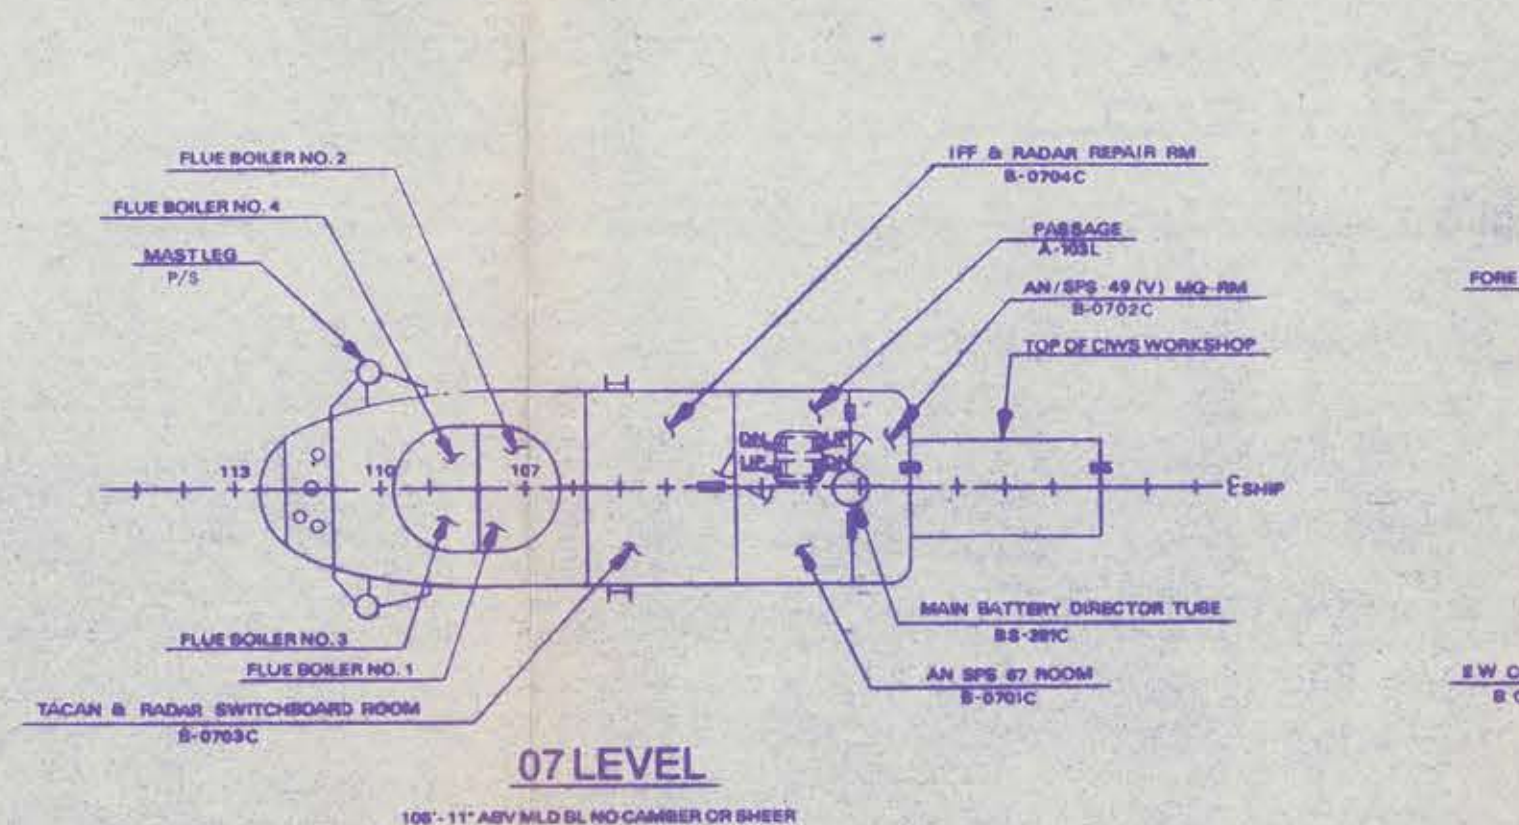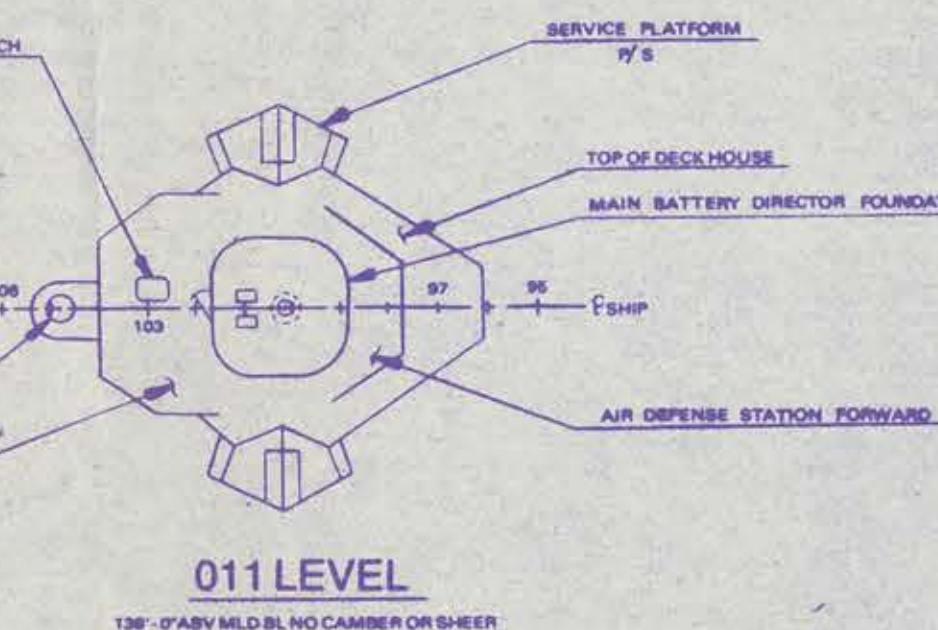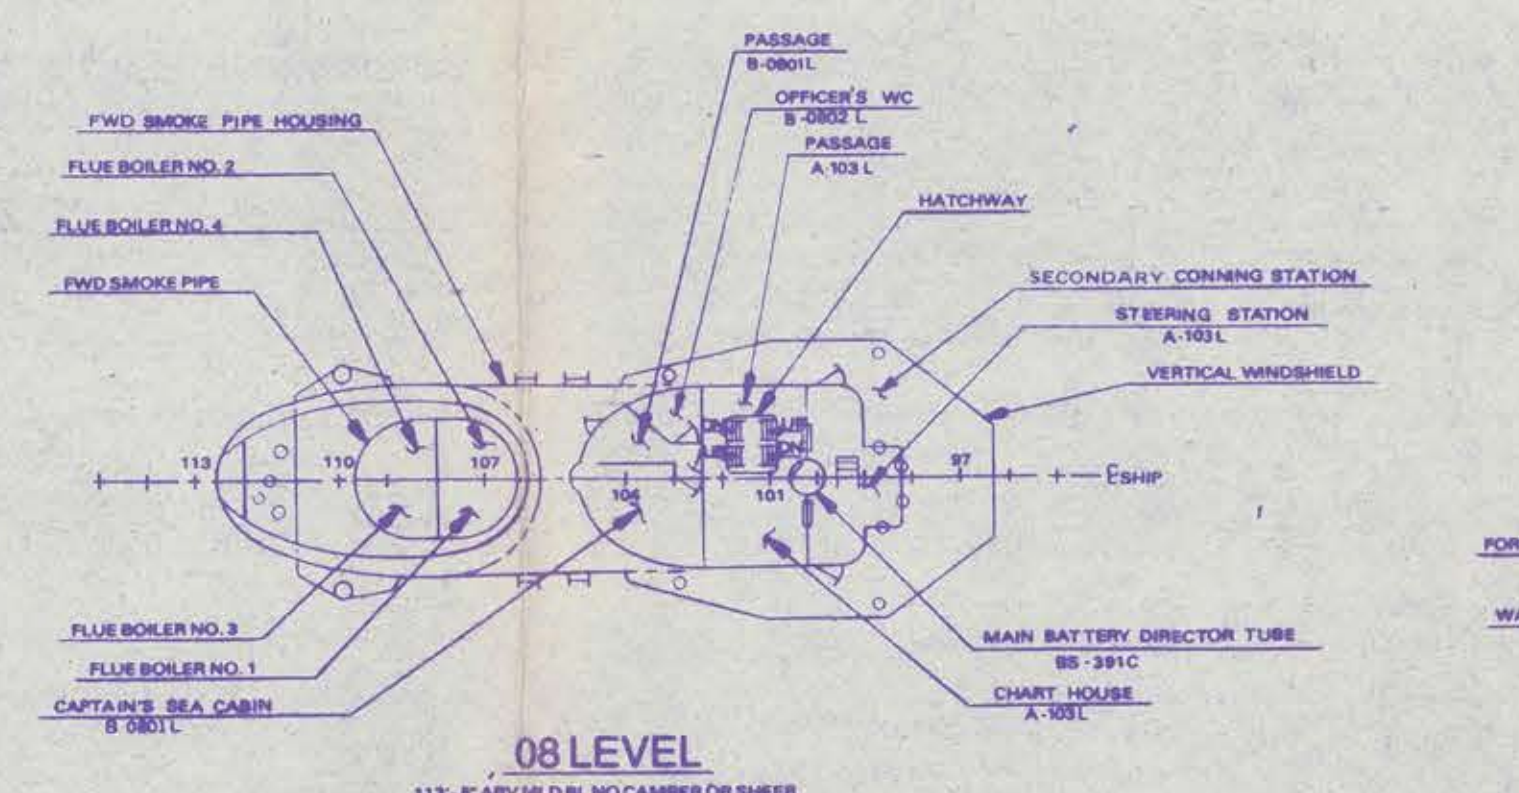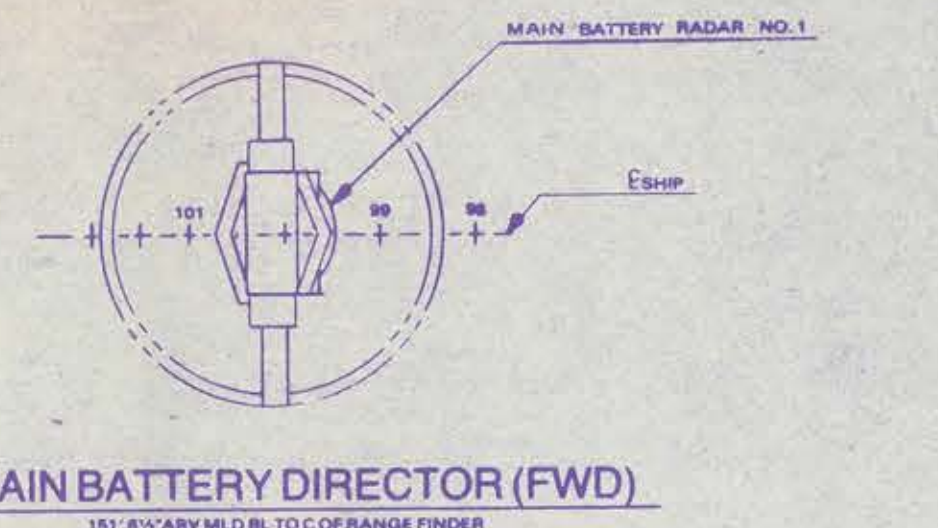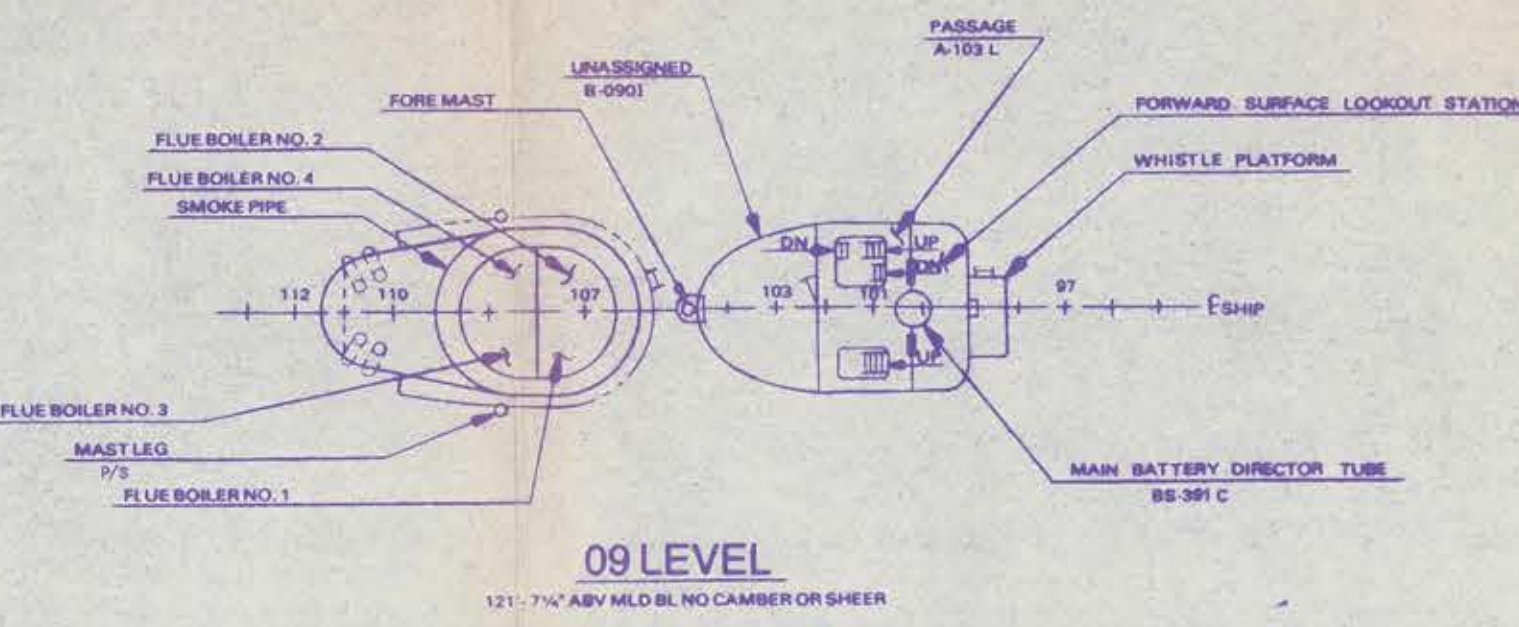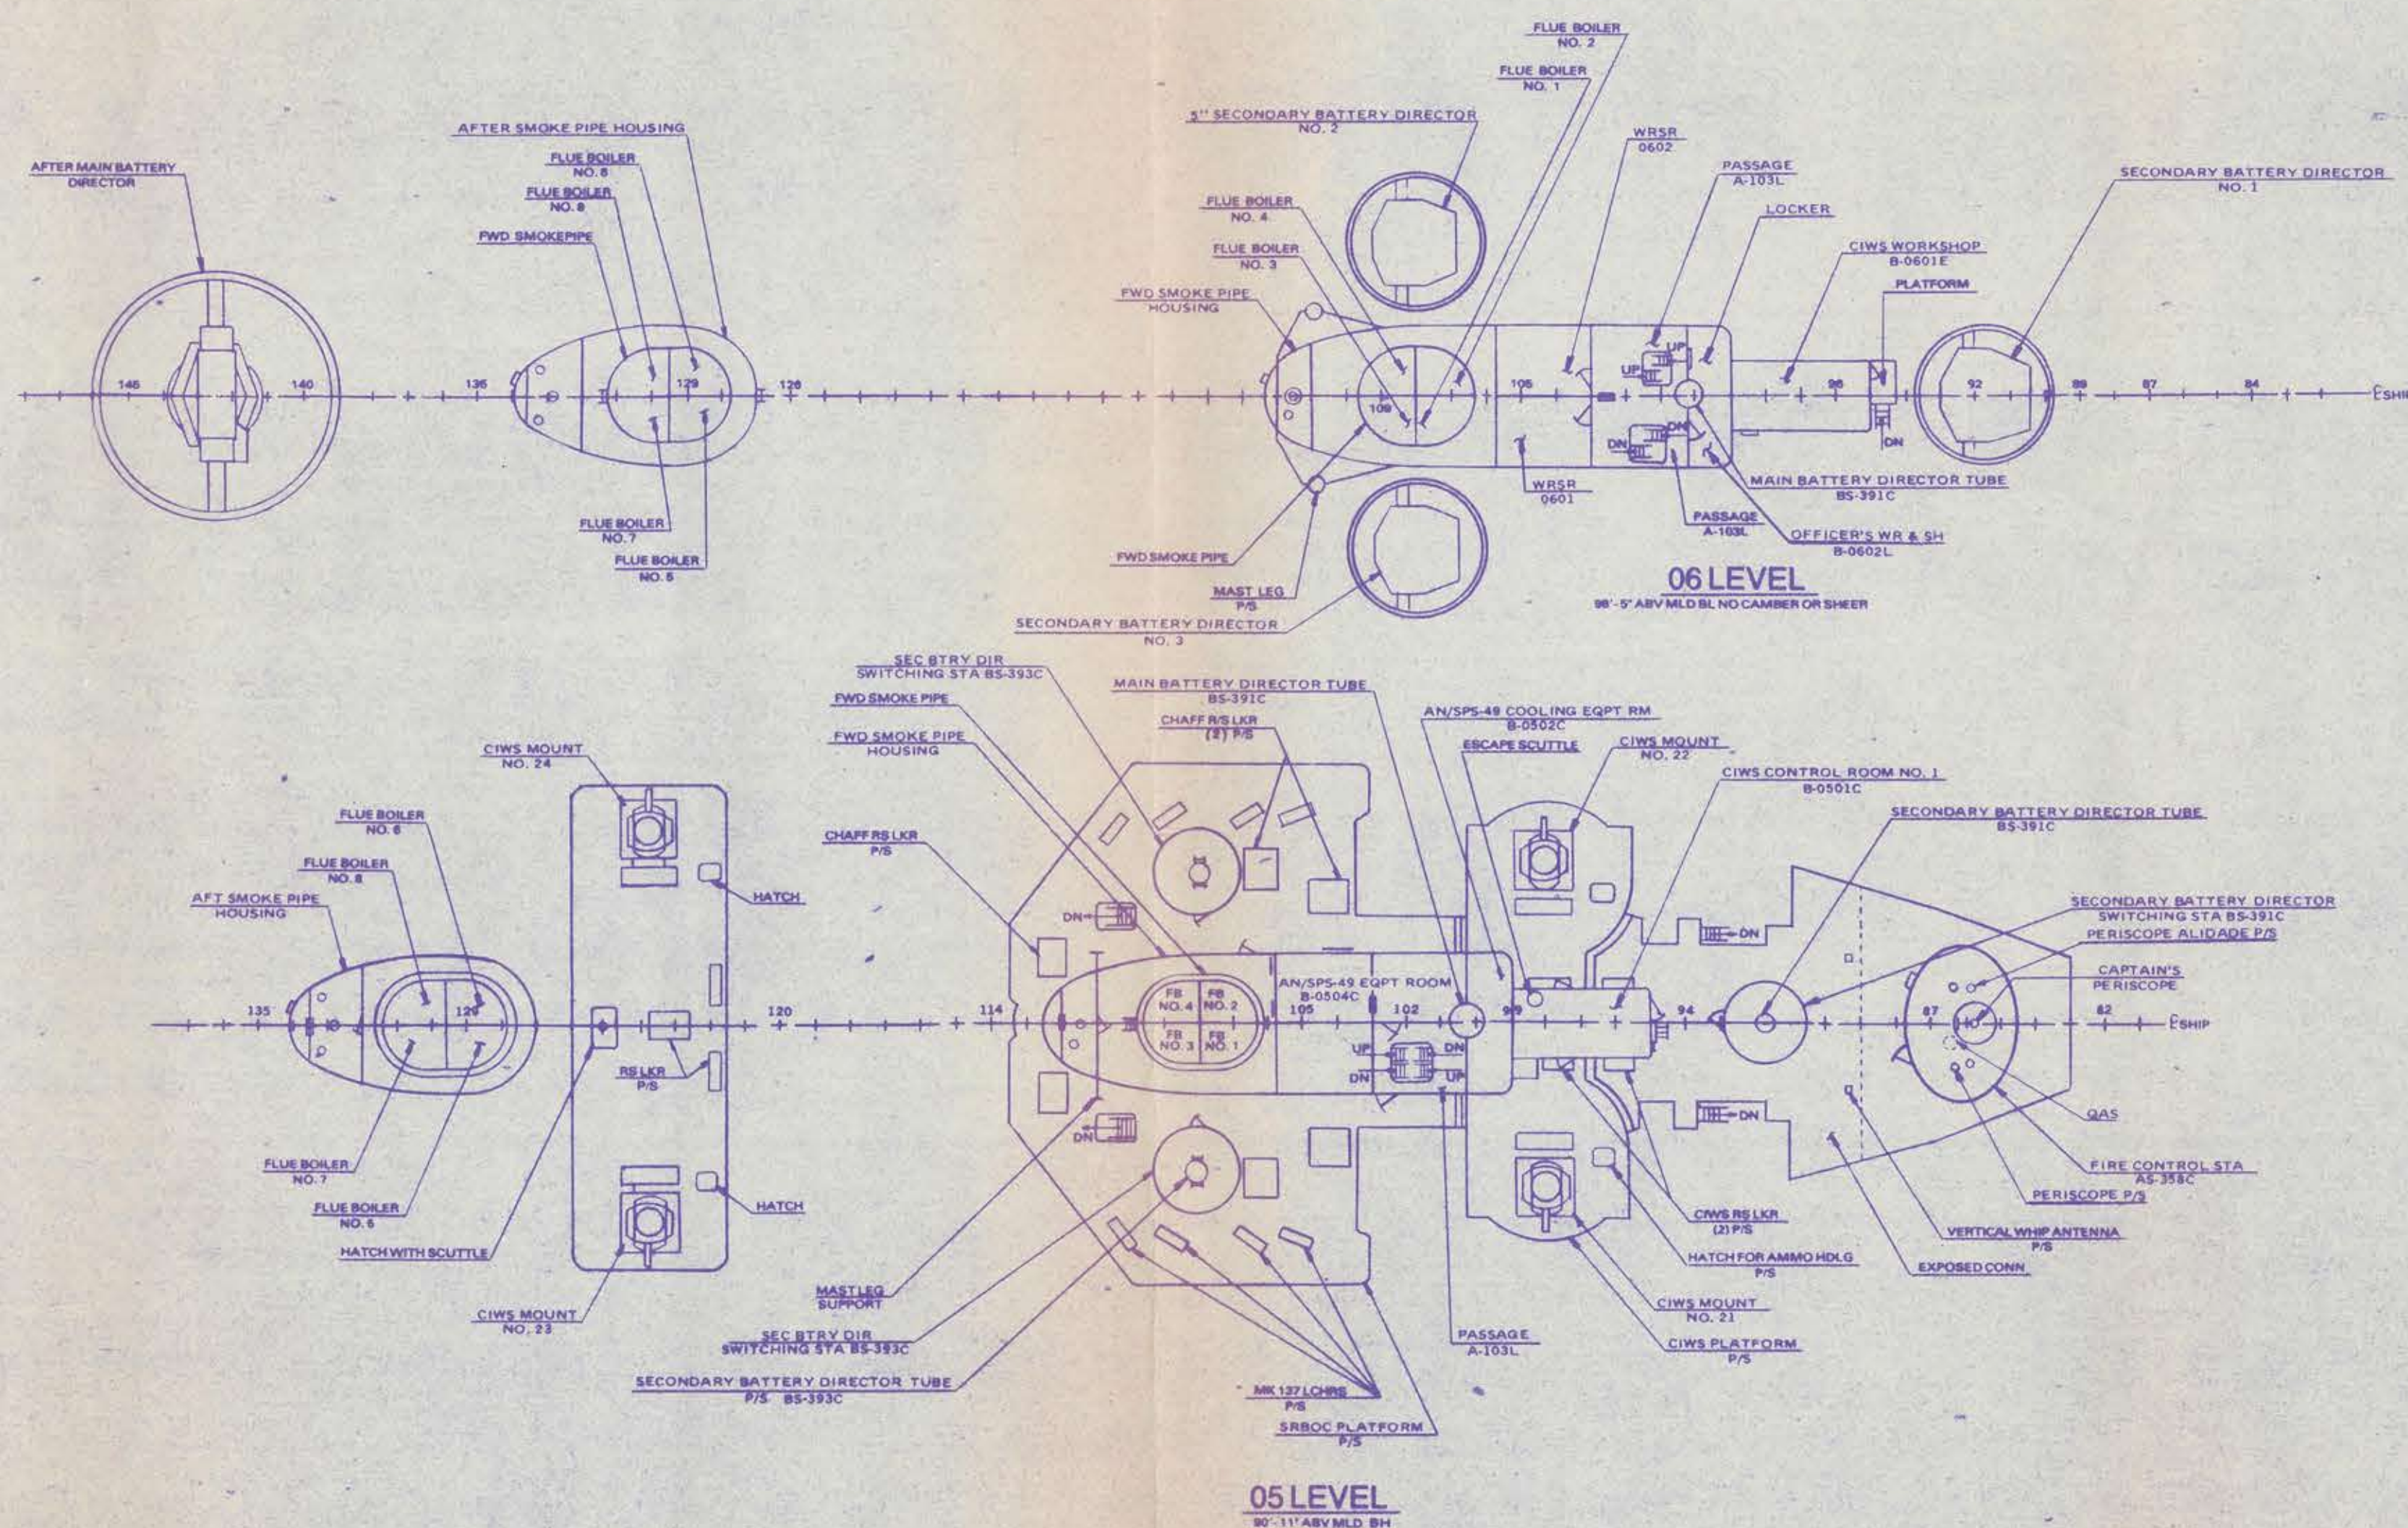
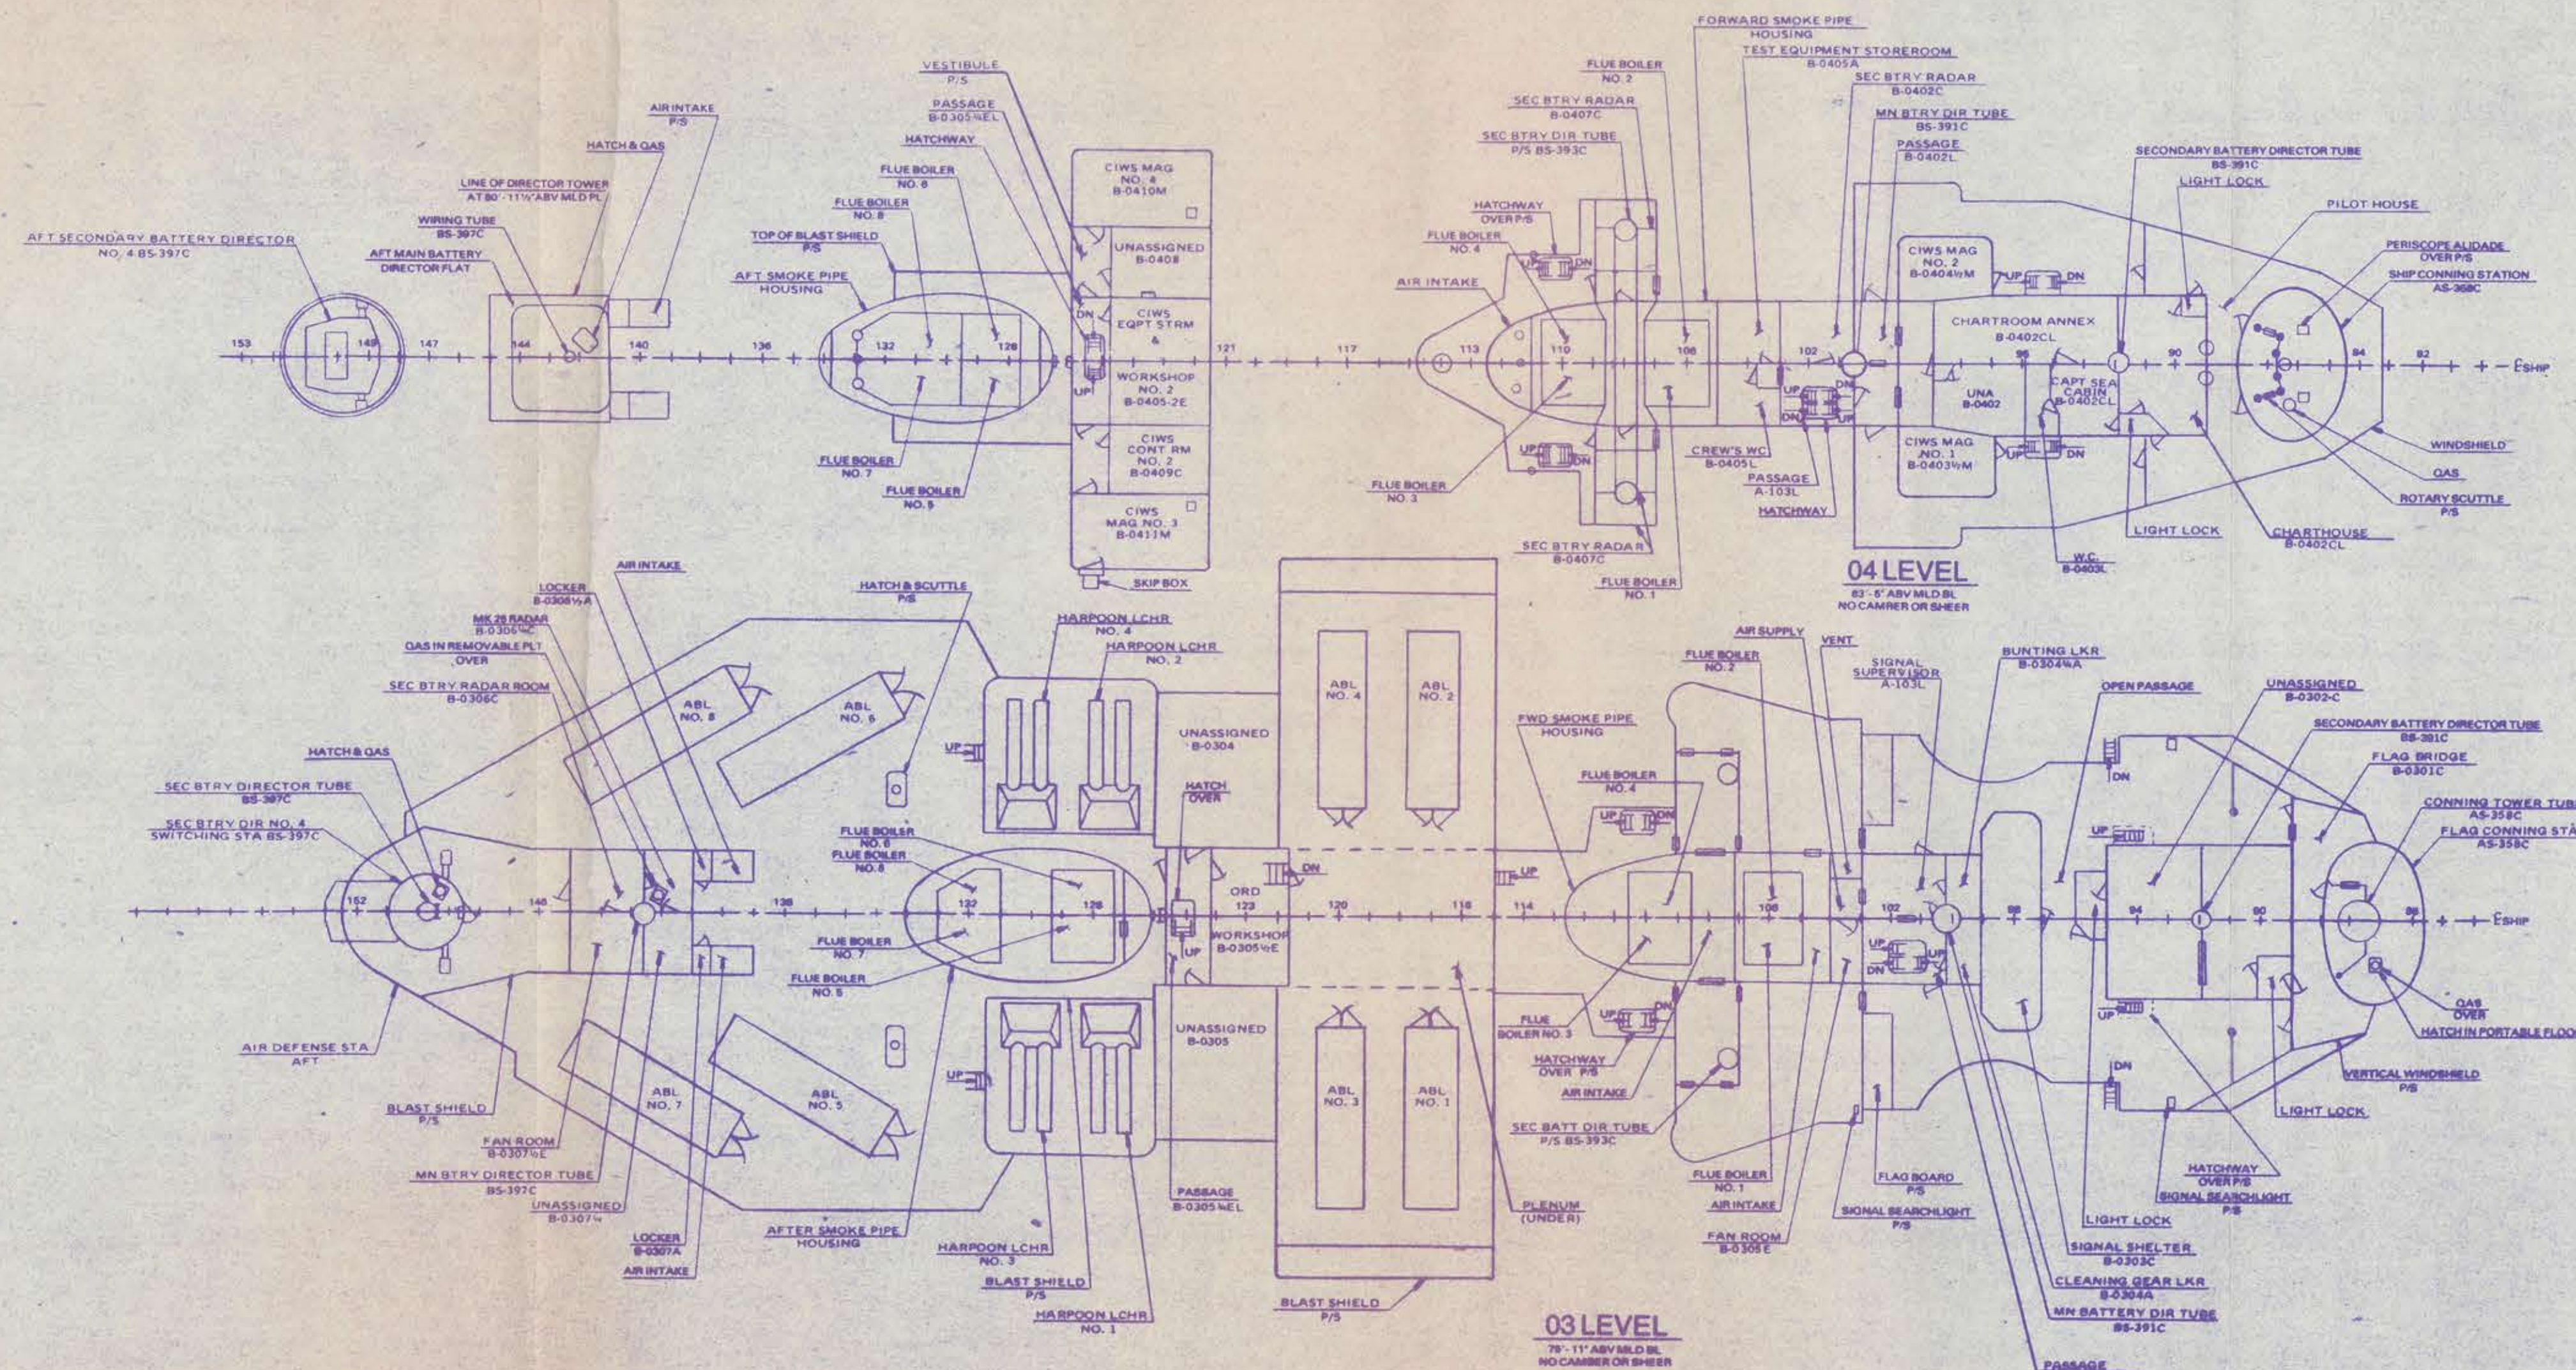


BRIDGES  
BU. NO. 578106  
SCALE: 1/16"=1'-0"  
PLATE 5 OF 18



CONFIDENTIAL

CONFIDENTIAL

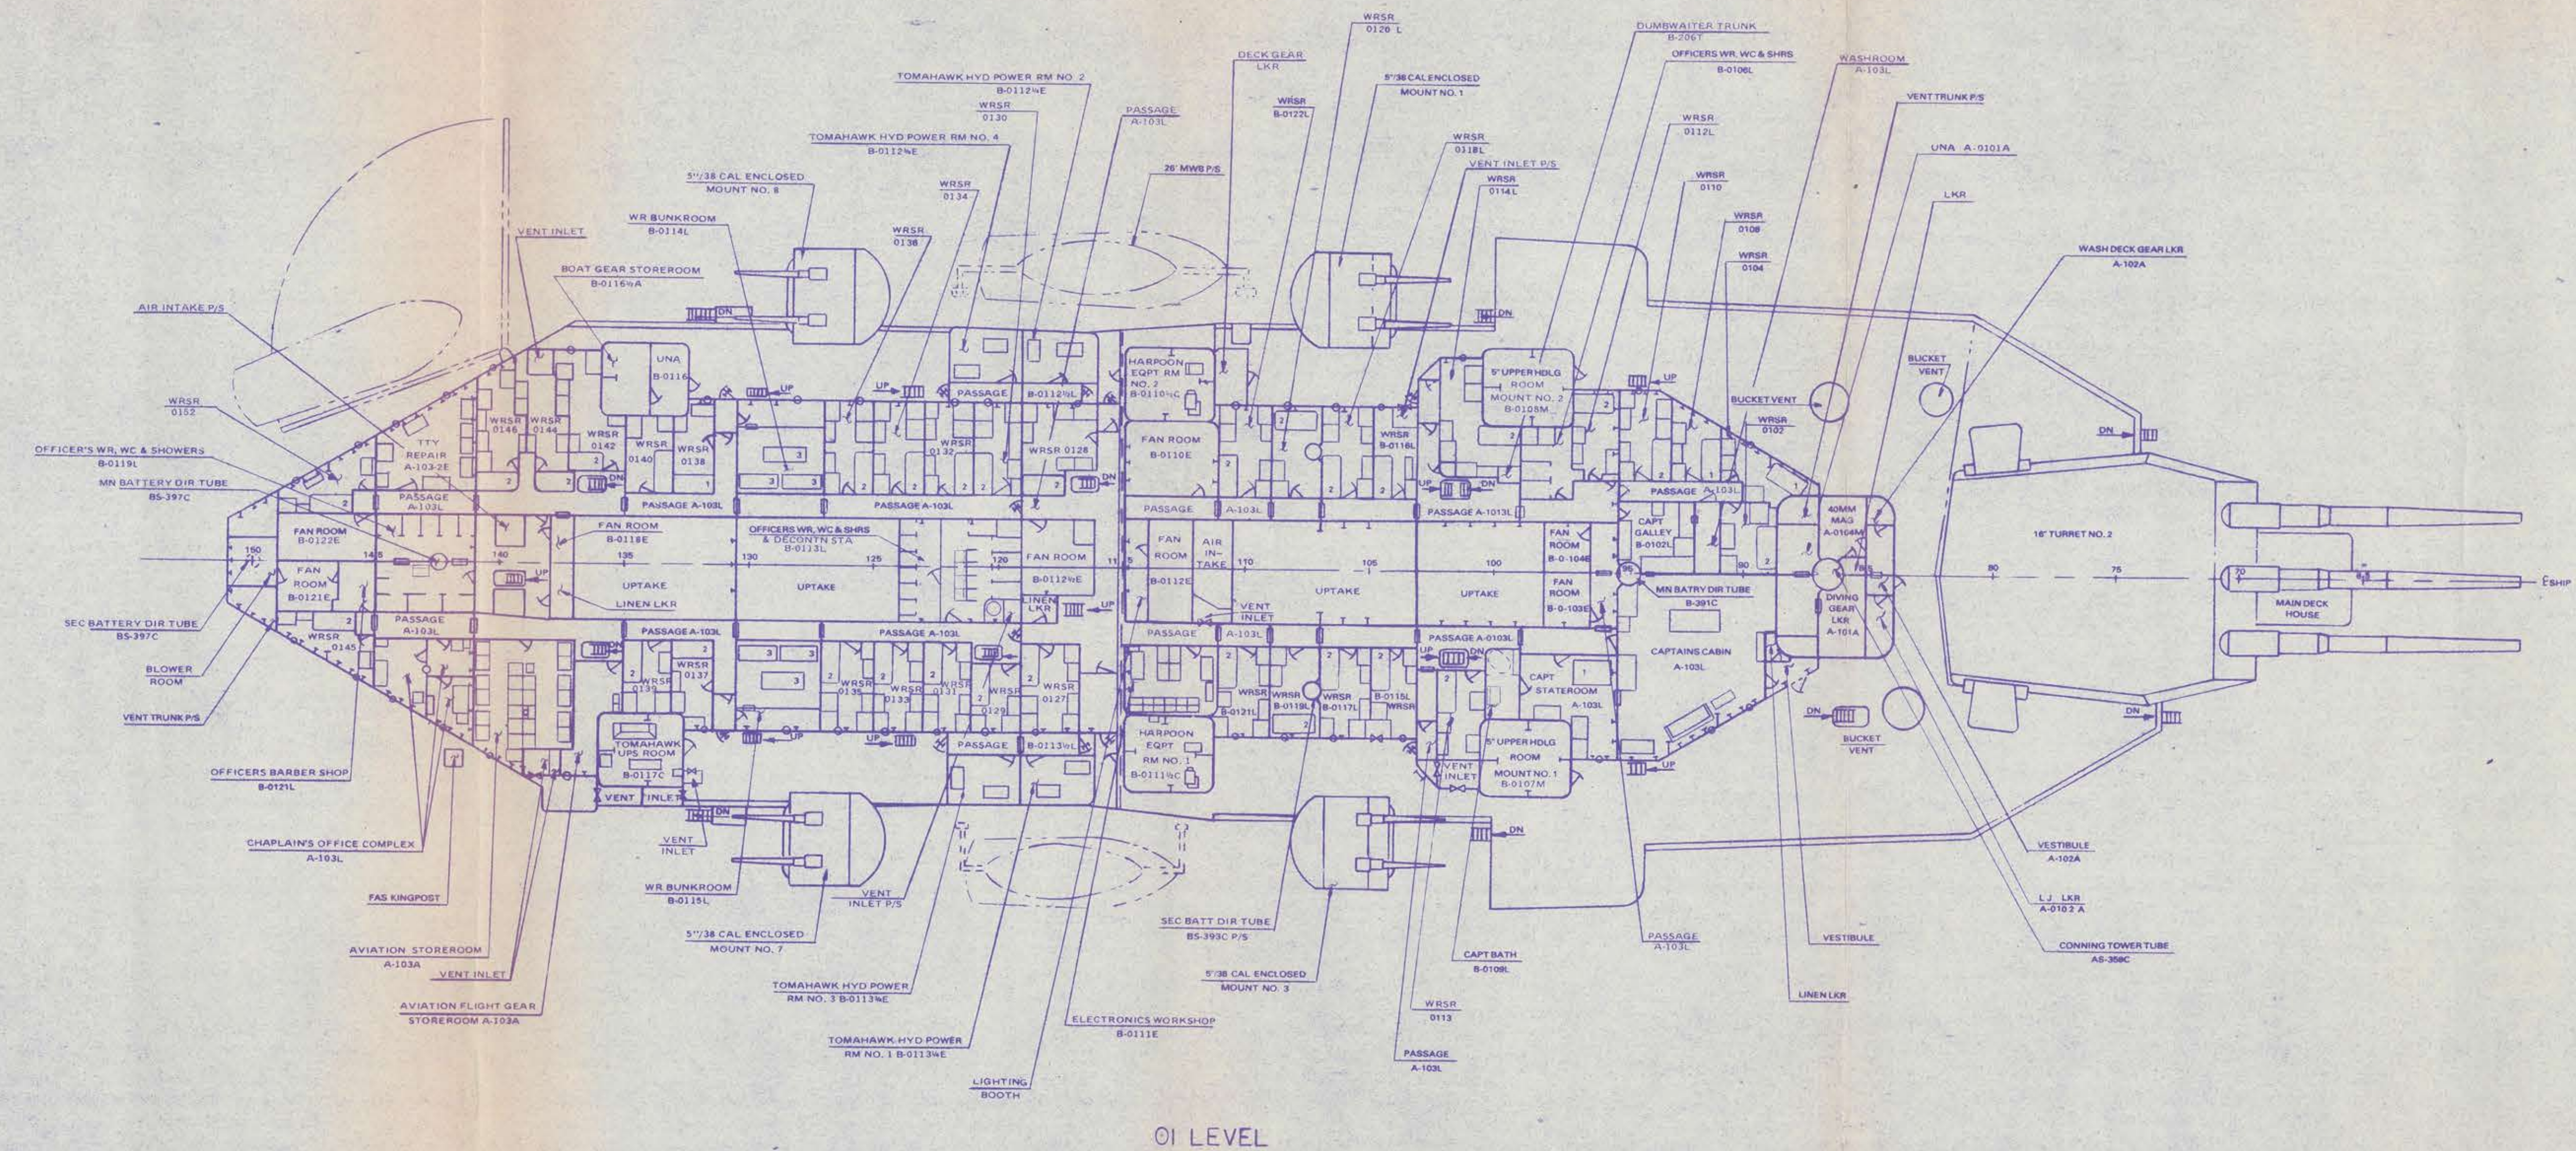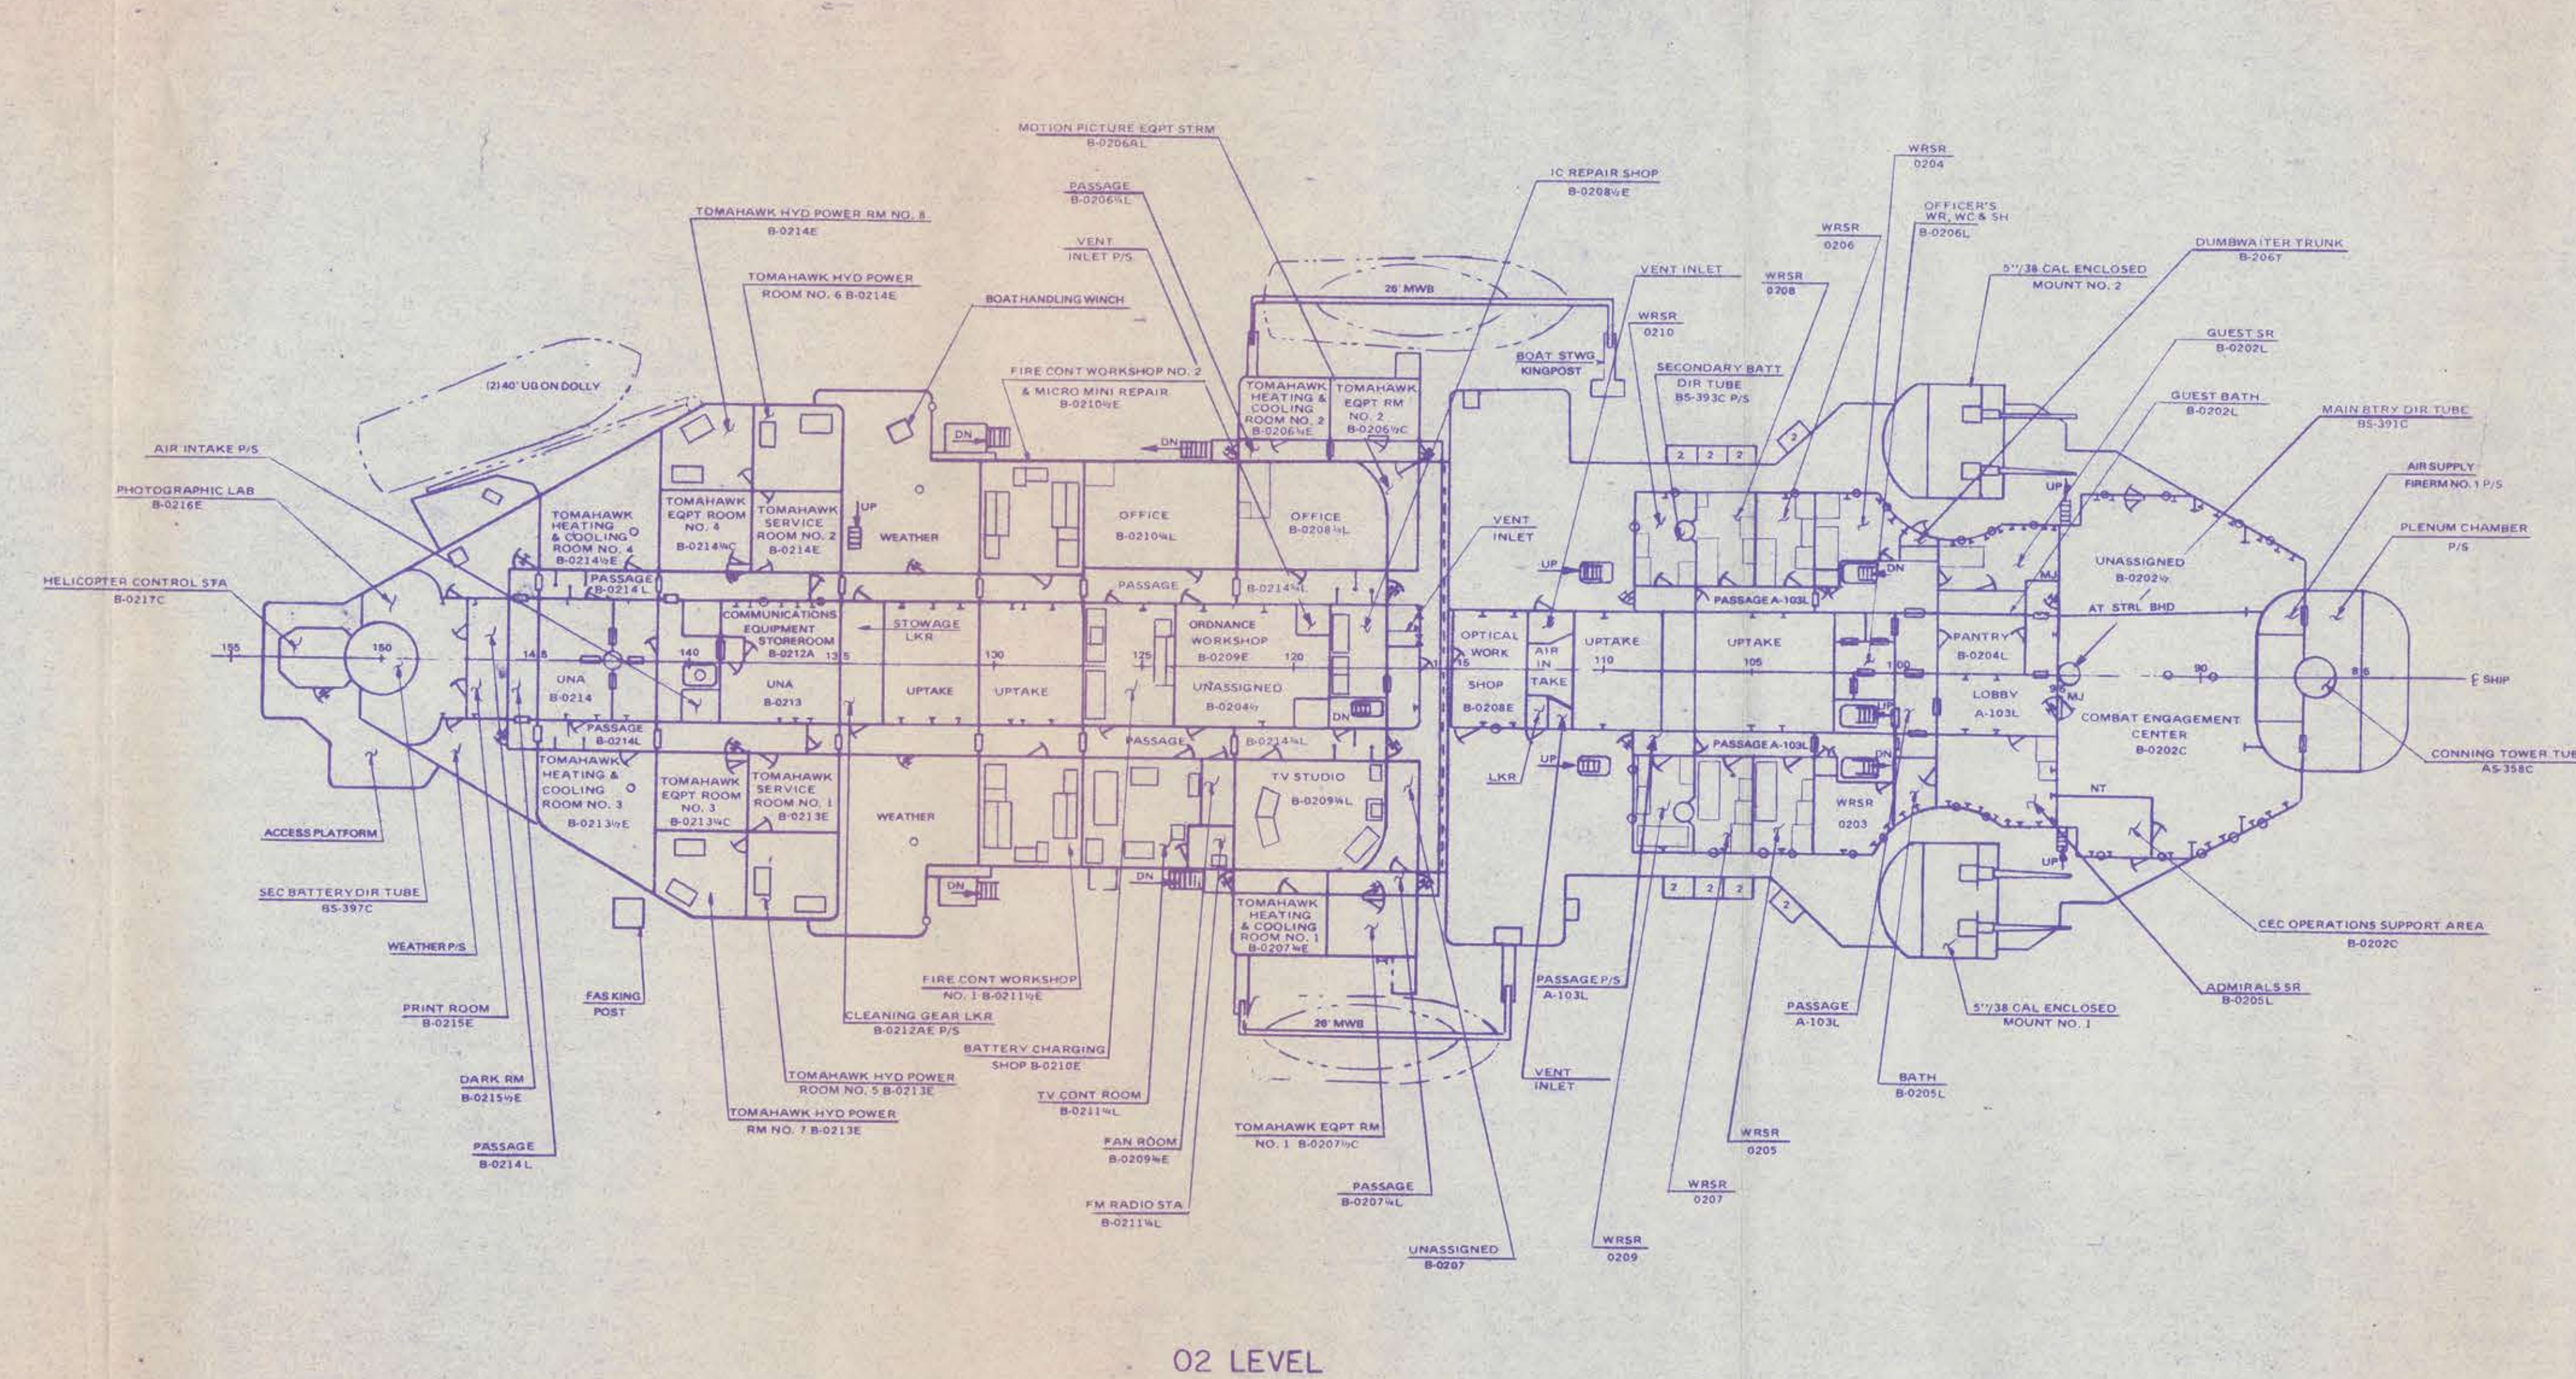


FIRST AND SECOND  
SUPERSTRUCTURE DECKS  
BU. NO. 578106  
SCALE : 1/16" = 1' - 0"  
PLATE 6 OF 18



CONFIDENTIAL

CONFIDENTIAL

 


MAIN DECK  
BU. NO. 578106\*  
SCALE: 1/16"=1'-0"  
PLATE 7 OF 18



CONFIDENTIAL

CONFIDENTIAL

 


SECOND DECK  
BU. NO. 578106  
SCALE:  $1/16" = 1'-0"$   
PLATE 8 OF 18



CONFIDENTIAL


CONFIDENTIAL

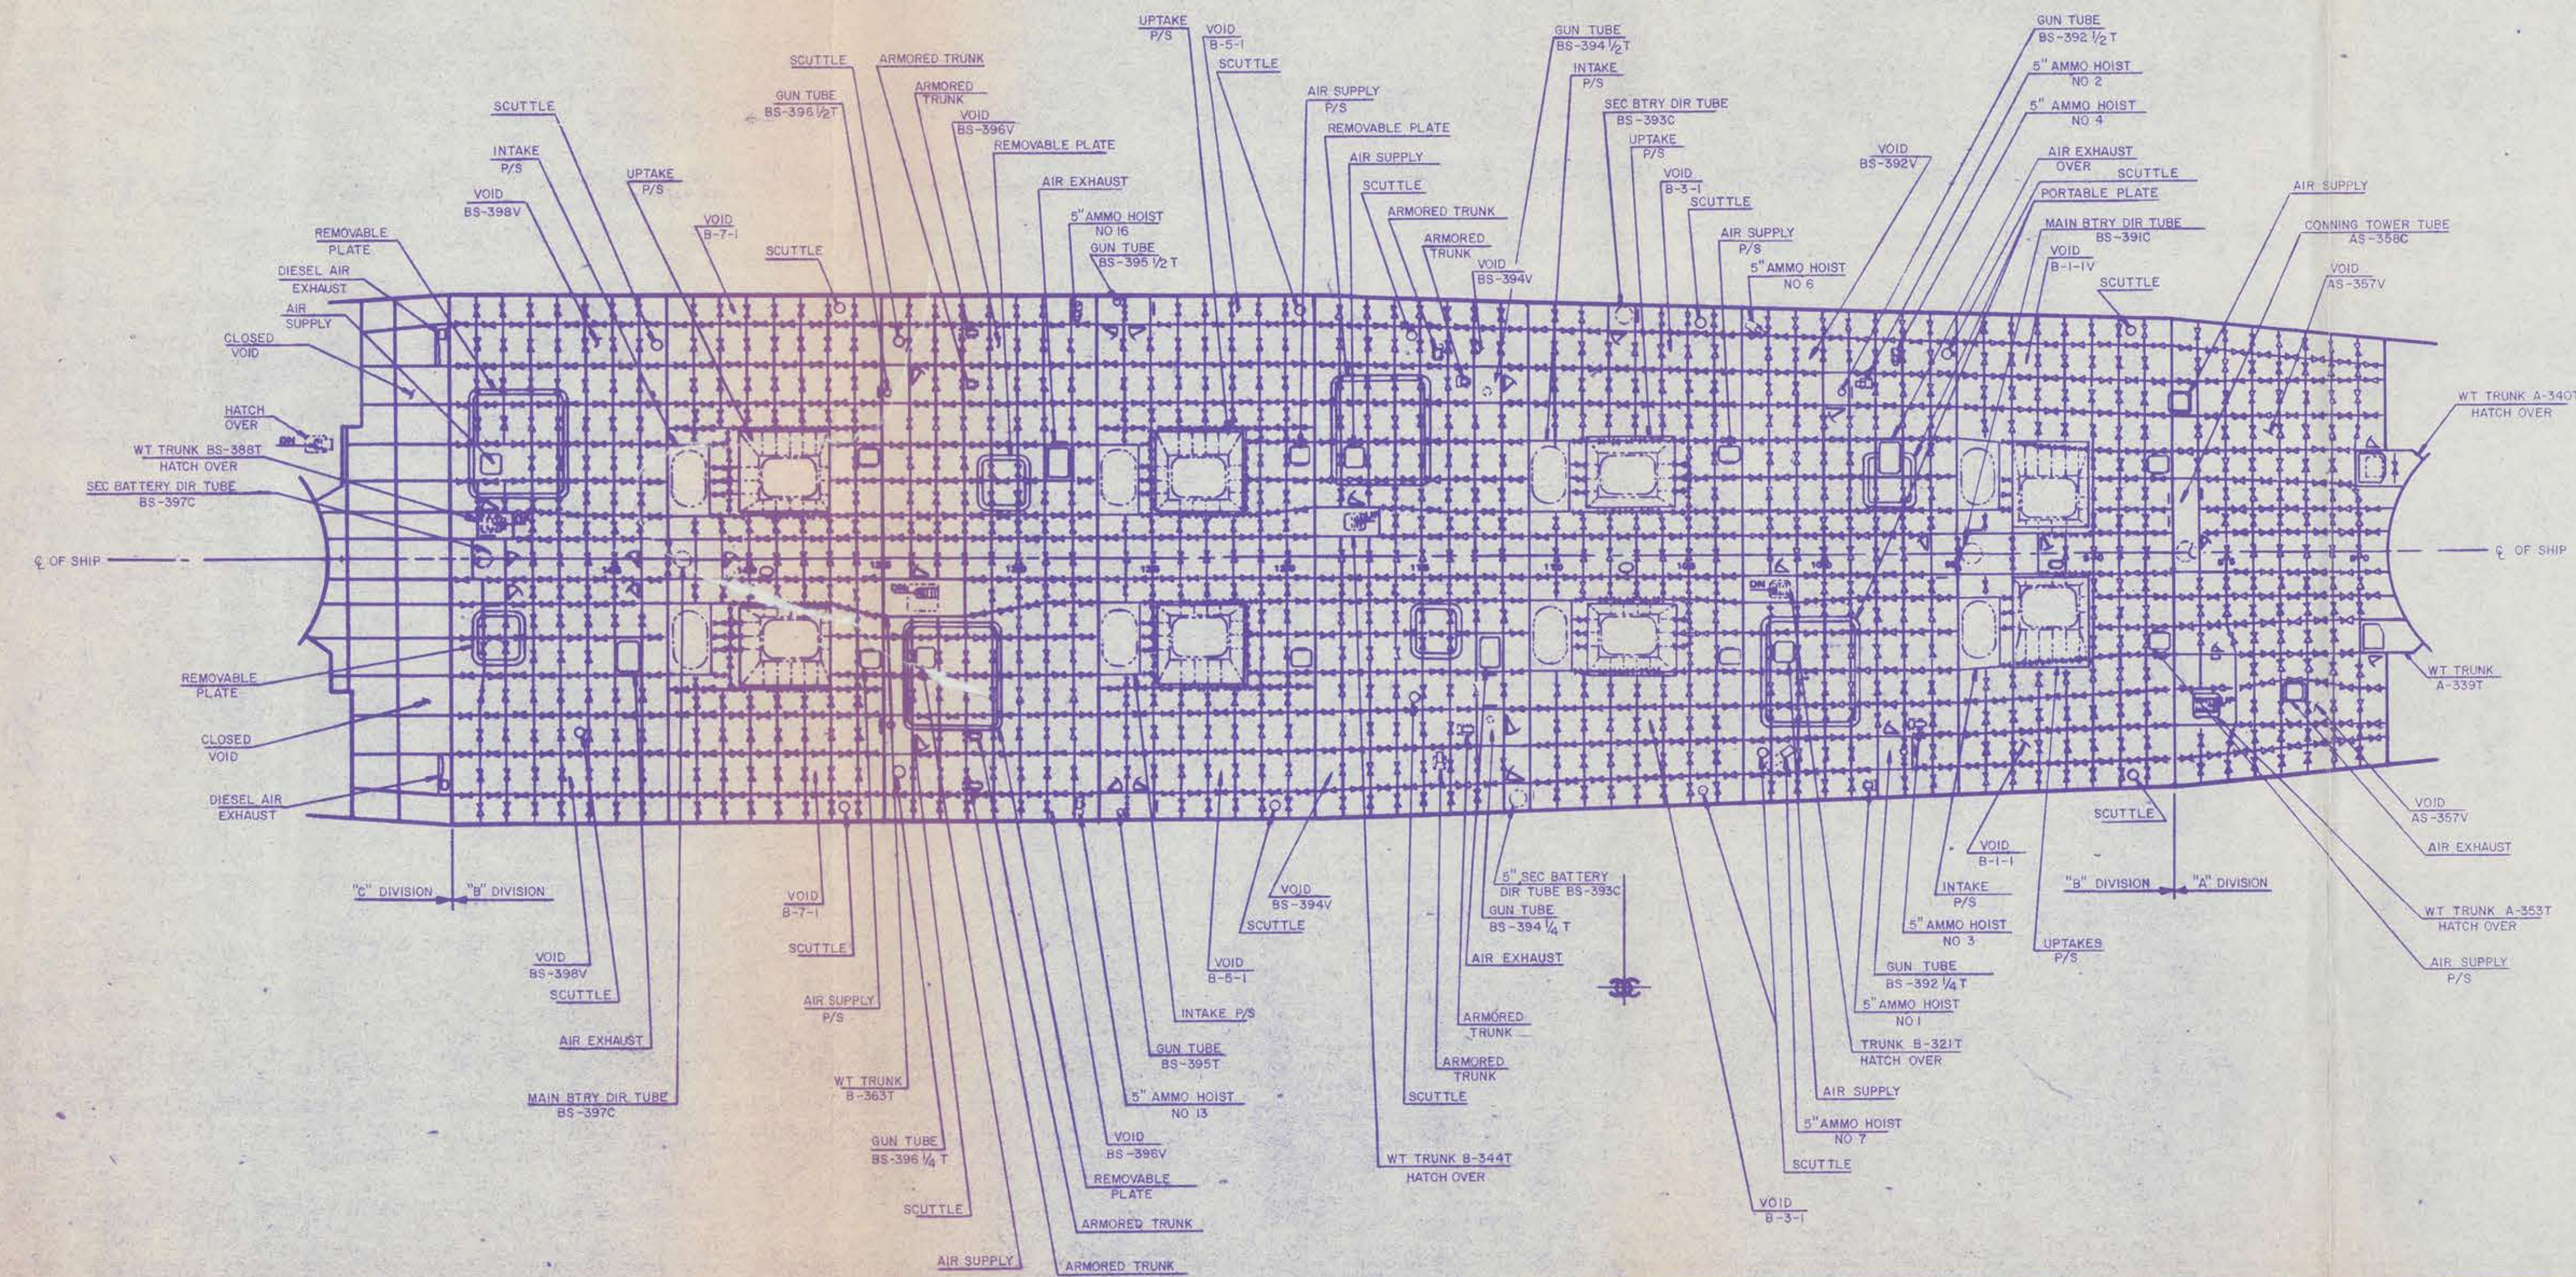

SPLINTER DECK  
BU. NO. 578106  
SCALE: 1/16"=1'-0"  
PLATE 9 OF 18



CONFIDENTIAL

 


CONFIDENTIAL

THIRD DECK  
BU. NO. 578106  
SCALE: 1/16"=1'-0"  
PLATE 10 OF 18



CONFIDENTIAL


CONFIDENTIAL

 

FIRST PLATFORM  
BU. NO. 578106  
SCALE: 1/16" = 1'-0"  
PLATE 11 OF 18



CONFIDENTIAL

 


SECOND AND THIRD  
PLATFORMS  
BU. NO. 578106  
SCALE: 1/16" = 1'-0"  
PLATE 12 OF 18



CONFIDENTIAL

CONFIDENTIAL

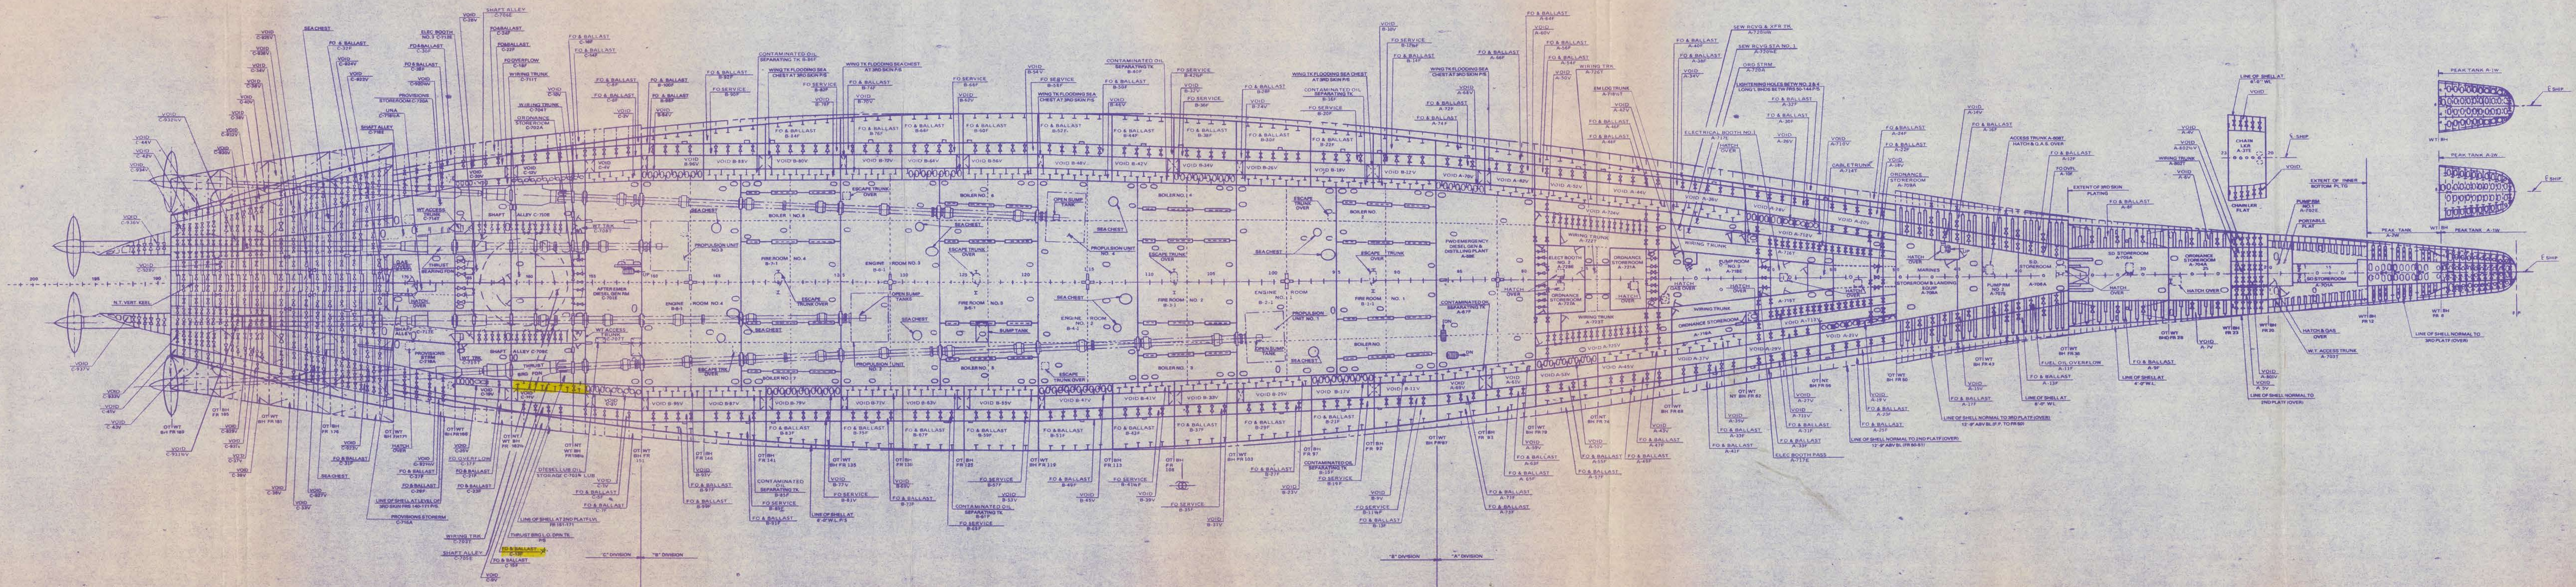


HOLD  
BU. NO. 578106  
SCALE 1/16"=1'-0"  
PLATE 13 OF 18



CONFIDENTIAL

CONFIDENTIAL

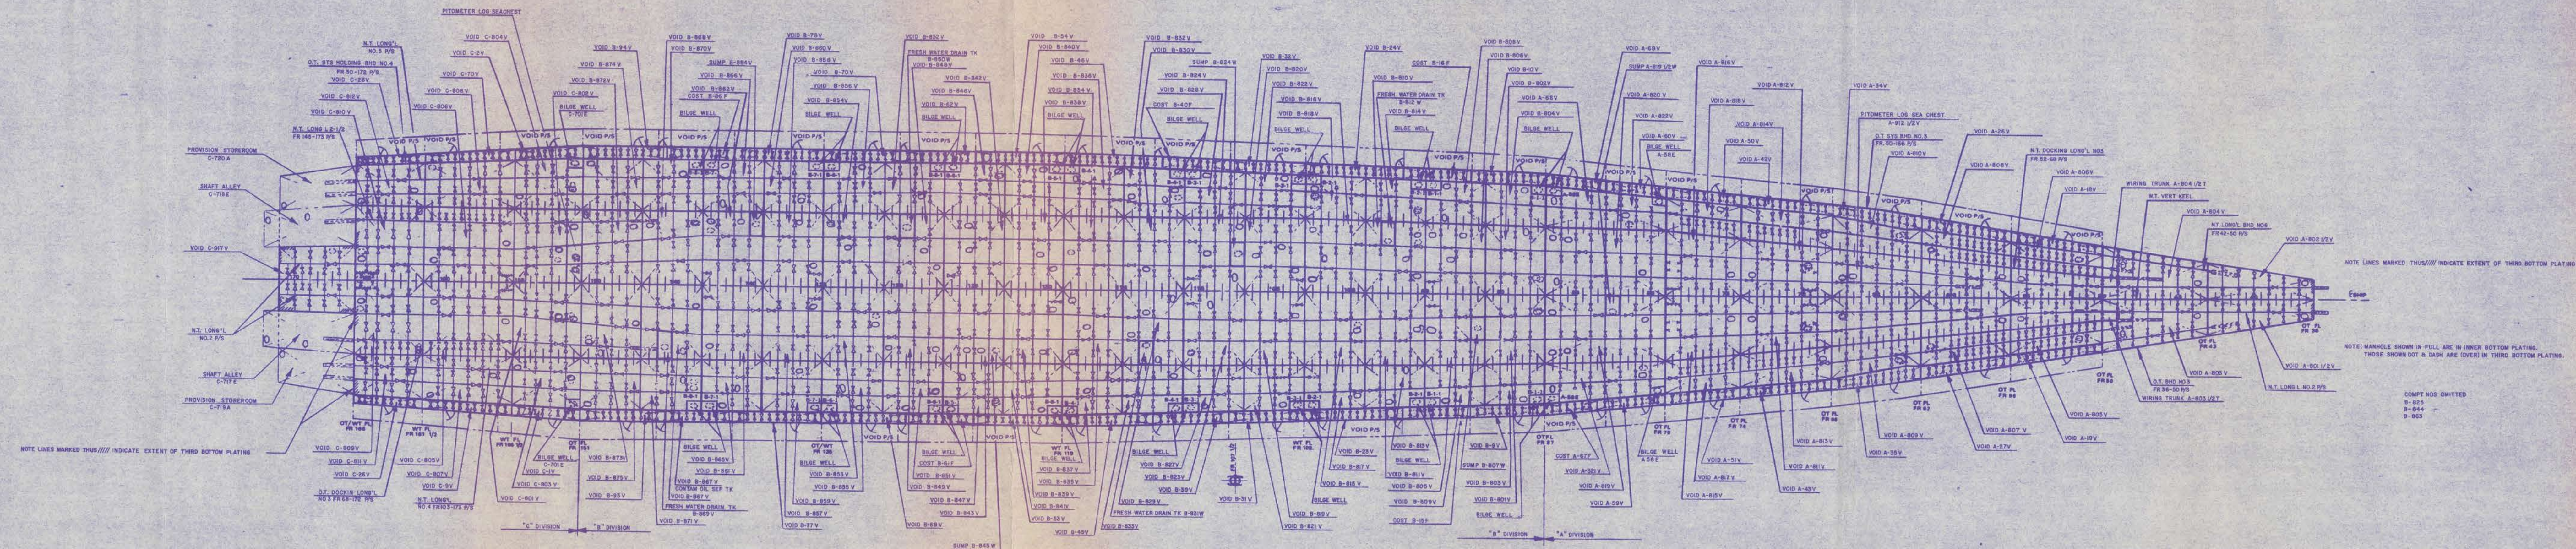

THIRD BOTTOM  
BU. NO. 57806  
SCALE: 1/16"=1'-0"  
PLATE 14 OF 18